


# CHRISTIANSTED TOWN WATERLINE REHABILITATION AS-BUILTS

## VIRGIN ISLANDS WATER AND POWER AUTHORITY

ST. CROIX, U.S. VIRGIN ISLANDS


JULY 2021

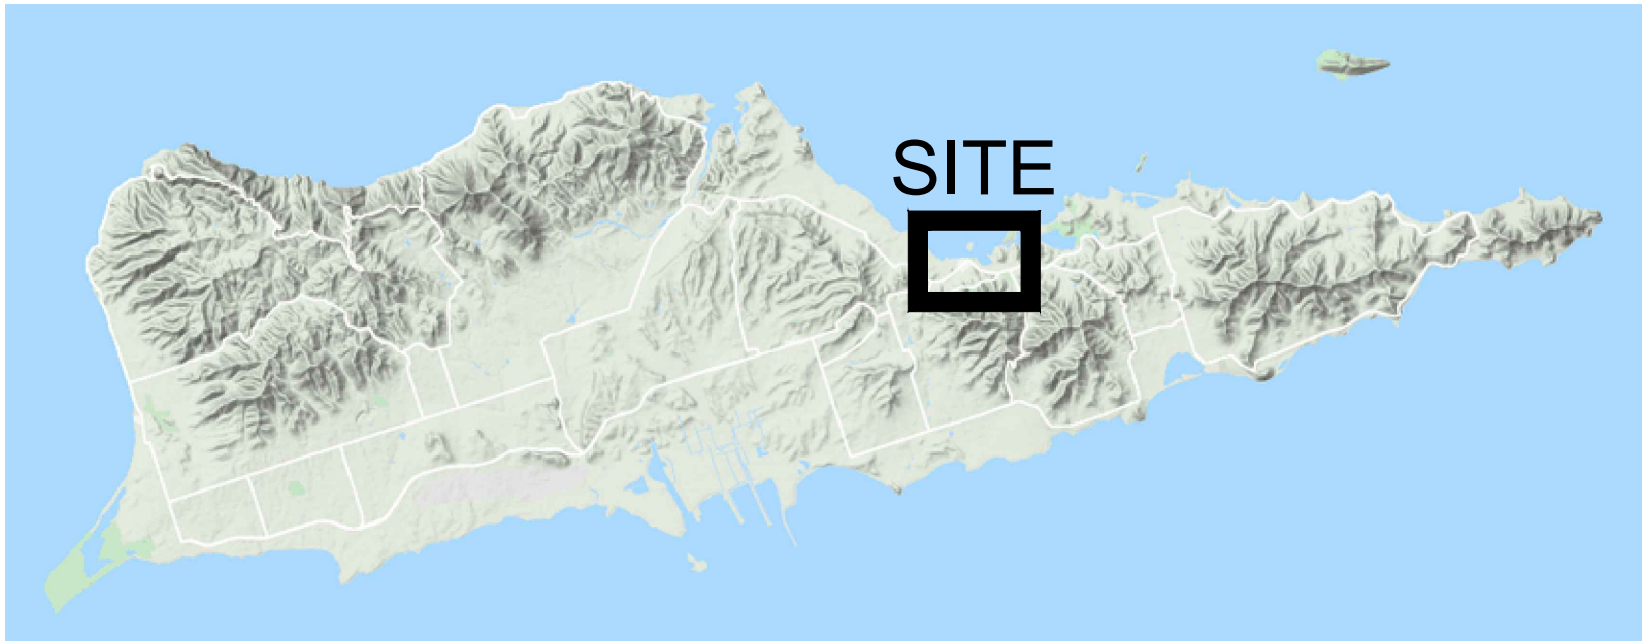

1 SITE PLAN VIEW  
Scale: 1" = 200'-0"

### SHEET INDEX

C01	LAYOUT OVERVIEW
C02	OVERALL VALVE MAP
C03	VALVE MAP SECTION AREA 1
C04	VALVE MAP SECTION AREA 2
C05	MARKET STREET PLAN AND PROFILE
C06	FISHER STREET PLAN AND PROFILE
C07 - 10	EAST STREET PLAN AND PROFILE
C11 - 14	HILL STREET PLAN AND PROFILE
C15 - 18	QUEEN STREET PLAN AND PROFILE
C19 - 20	KING CROSS STREET PLAN AND PROFILE
C21 - 23	QUEEN CROSS STREET PLAN AND PROFILE
C24 - 25	CHURCH STREET PLAN AND PROFILE
C26 - 27	HOSPITAL STREET PLAN AND PROFILE

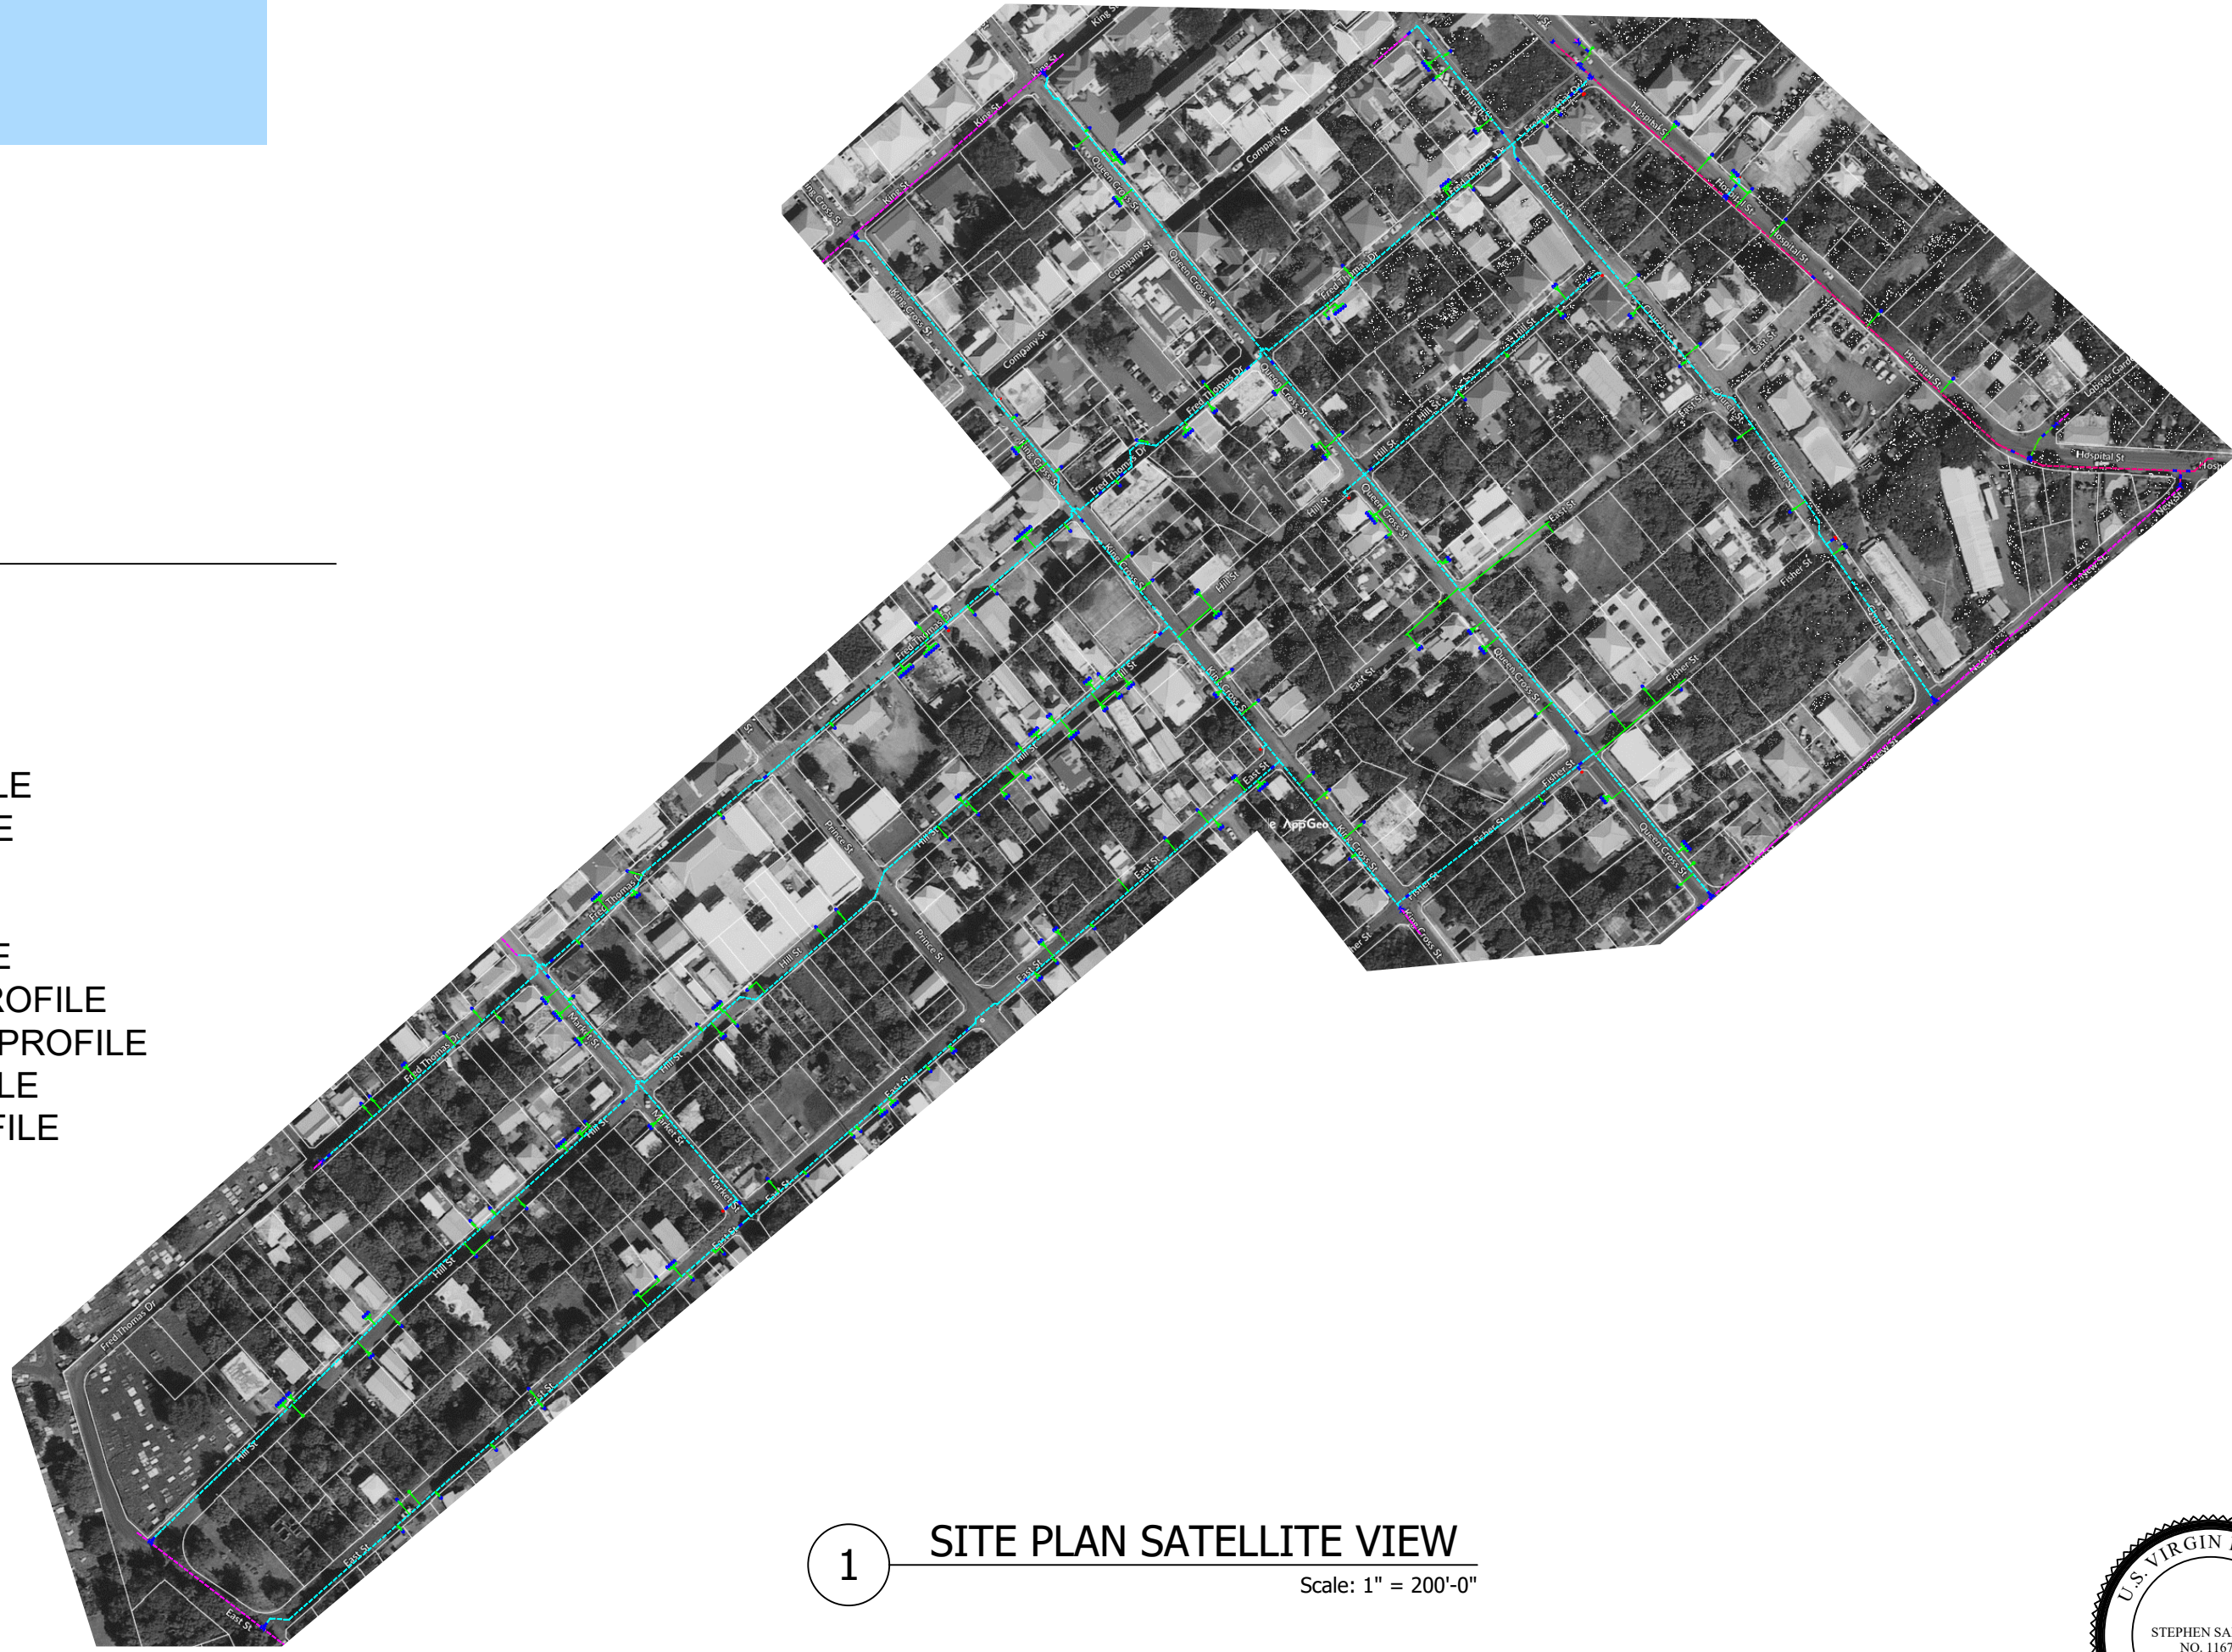

1 SITE PLAN SATELLITE VIEW  
Scale: 1" = 200'-0"



VIRGIN ISLANDS WATER AND POWER AUTHORITY


P.O. BOX 1009 CHRISTIANSTED, ST. CROIX, U.S. VIRGIN ISLANDS







P.O. BOX 3520, KINGSHILL, VI, 00851  
340.277.2788  
shsamuel@gmail.com



P.O. BOX 425  
CHRISTIANSTED, VI 00821  
elisa.sanchez@ejspmgroup.com

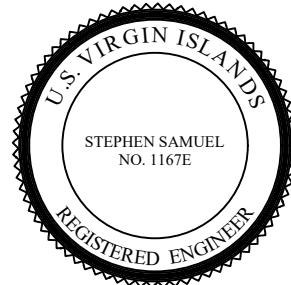



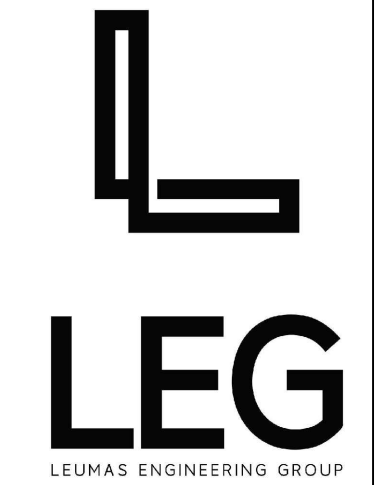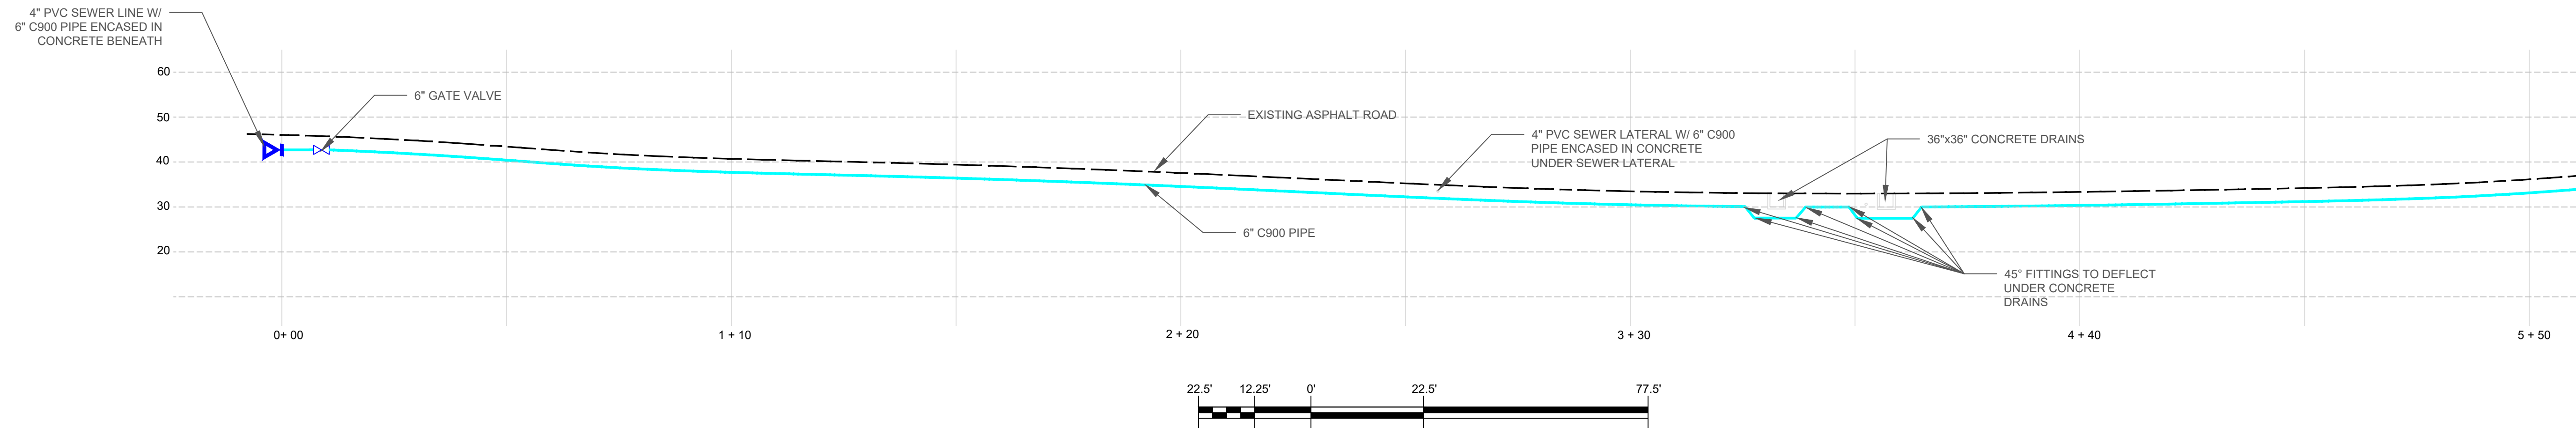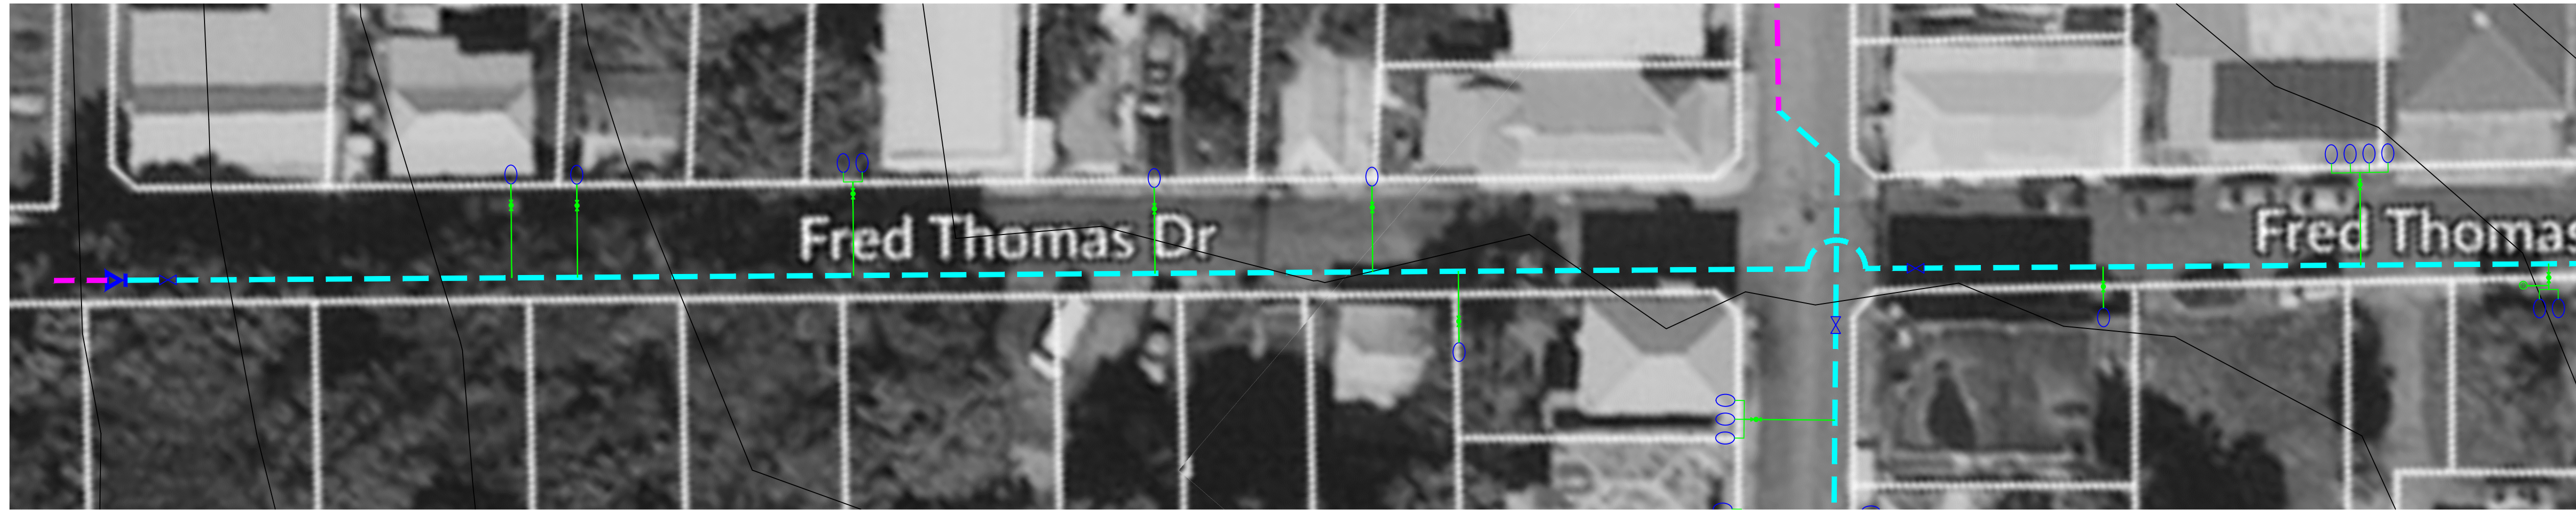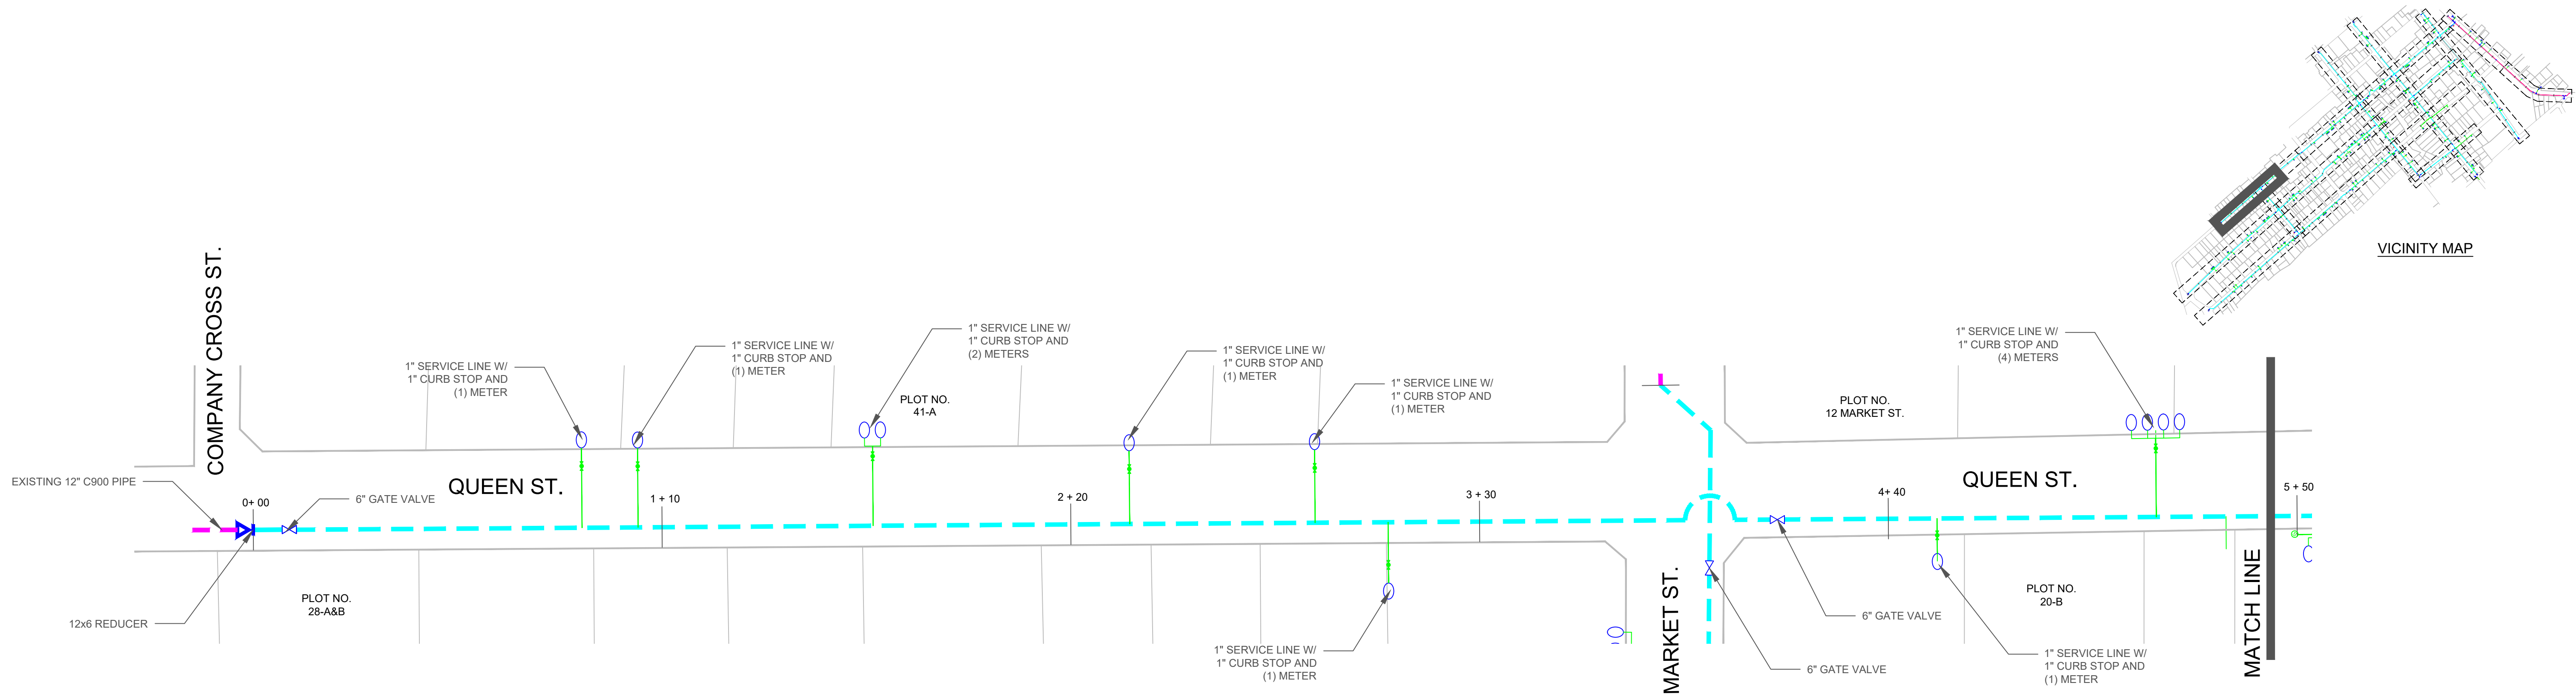


P.O. BOX 3520  
KINGSHILL, VI, 00851  
340.277.2788  
shsamuel@gmail.com

CHRISTIANSTOWN WATERLINE REHABILITATION AS-BUILT  
**VIRGIN ISLANDS WATER AND POWER AUTHORITY**  
P.O. BOX 1009 CHRISTIANSTOWN, ST. CROIX, U.S. VIRGIN ISLANDS

REVISIONS		
No.	DESCRIPTION	DATE

**PROJECT INFORMATION**  
**CONTRACT NO.:**  
SC 08 19  
**VIWAPA PROJECT MANAGER:**  
BRIAN LEONARD  
**VIWAPA PROJECT COORDINATOR:**  
GHADIR AWAWADA  
**CONSTRUCTION START DATE:**  
JUNE 9, 2019  
**CONSTRUCTION COMPLETION DATE:**  
FEBRUARY 17, 2021  
**PRIME CONTRACTOR:**  
LEUMAS ENGINEERING GROUP  
**PRIME CONTRACTOR CONTACT:**  
STEPHEN SAMUEL  
shsamuel@gmail.com

**QUEEN ST.  
PROFILE AND PLAN  
SECTION 1**

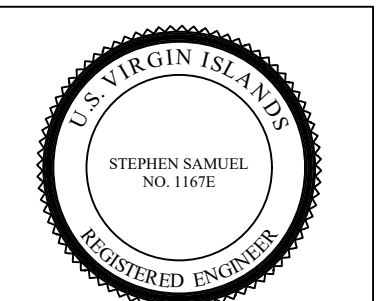

DATE  
JULY 2021  
DRAWN BY  
SHS  
SCALE  
AS NOTED  
**C15**  
15 OF 27





**VIRGIN ISLANDS WATER AND  
POWER AUTHORITY**

REVISIONS	
DESCRIPTION	DATE

## PROJECT INFORMATION

TRACT NO.:  
8 19

APA PROJECT MANAGER:  
N LEONARD

APA PROJECT  
ORDINATOR:  
DIR AWAWADA


**INSTRUCTION START**  
**E:**  
**E 9, 2019**

**COMPLETION DATE:**  
FEBRUARY 17, 2021




**THE CONTRACTOR:**  
MAS ENGINEERING  
GROUP

**THE CONTRACTOR  
CONTACT:**  
PHEN SAMUEL  
smuel@gmail.com

SECTION 2

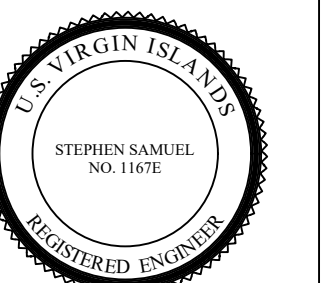


21	<div style="border: 1px solid black; padding: 10px; text-align: center;"> <h1>C16</h1> <p>18 OF 27</p> </div>
OWN BY	
E	
ED	

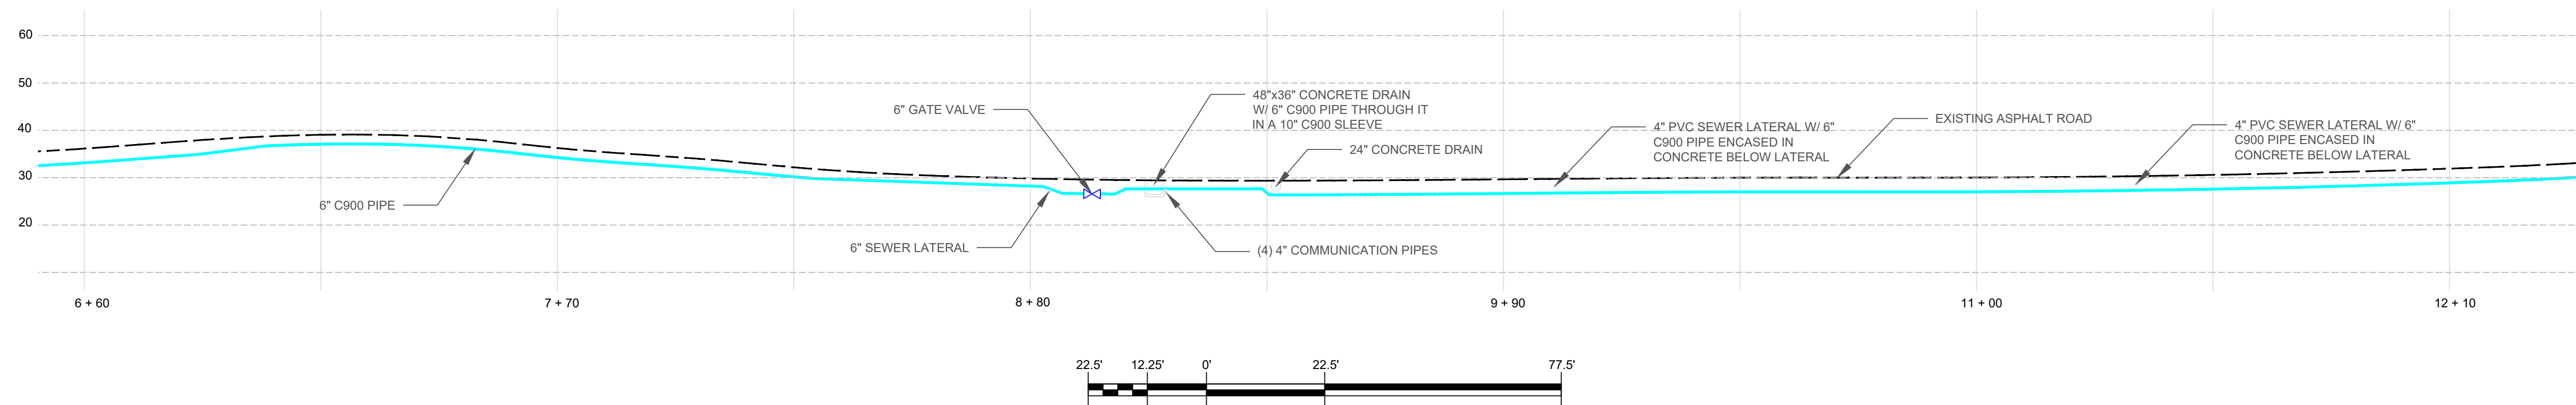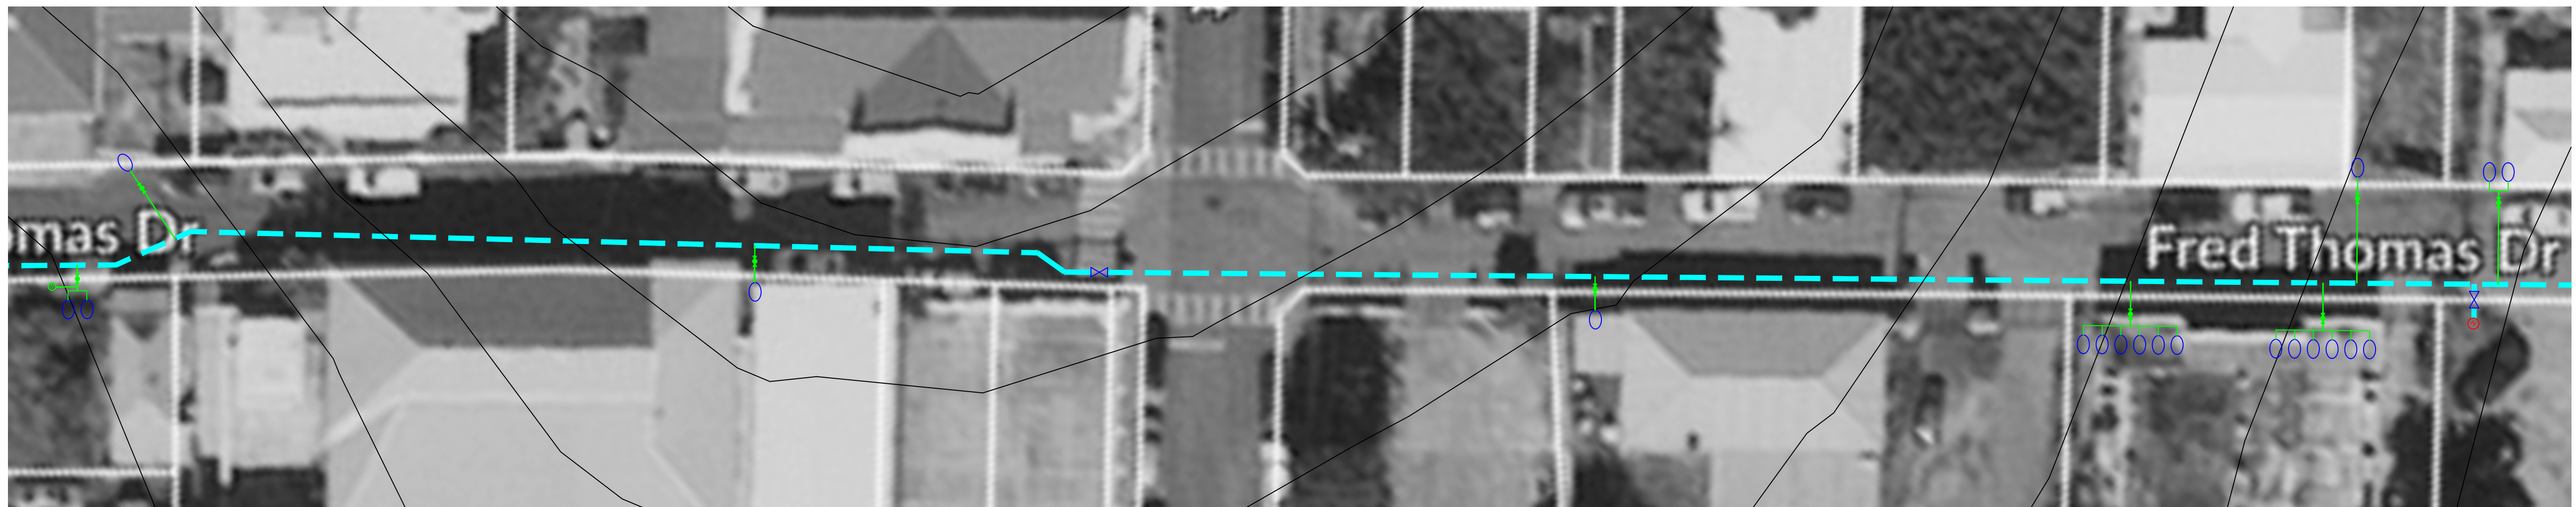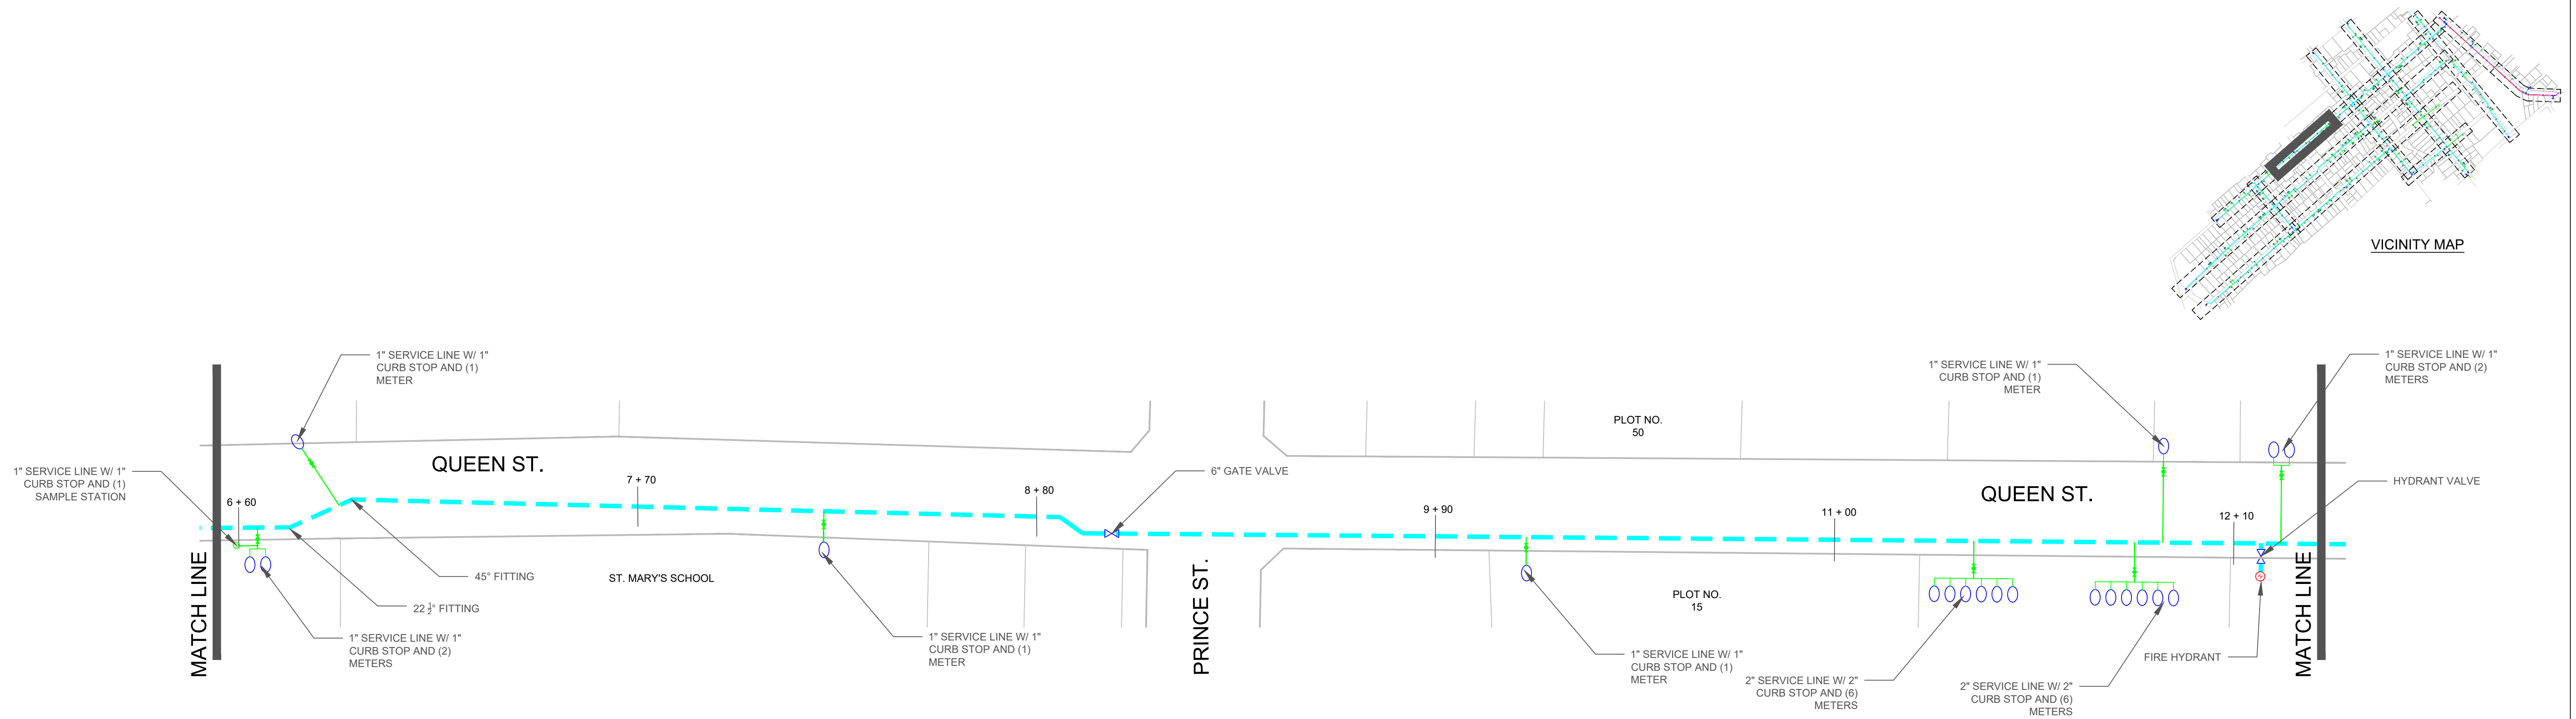

©COPYRIGHT: USE OF THIS DRAWING WITHOUT AUTHORIZATION OF STEPHEN SAMUEL OR THE SAID OWNER IS PROHIBITED WITHOUT THEIR WRITTEN CONSENT.



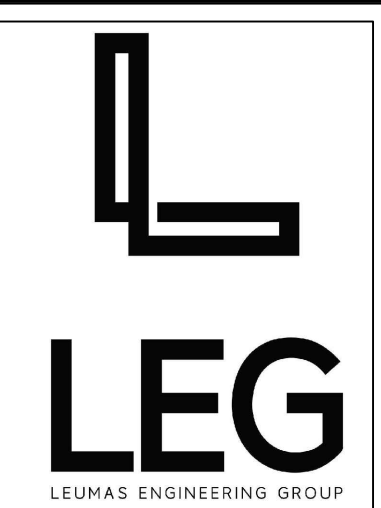

P.O. BOX 3520  
KINGSHILL, VI, 00851  
340.277.2788  
shsamuel@gmail.com

CHRISTIANSTED TOWN WATERLINE REHABILITATION AS-BUILT  
**VIRGIN ISLANDS WATER AND POWER AUTHORITY**  
P.O. BOX 1009 CHRISTIANSTED, ST. CROIX, U.S. VIRGIN ISLANDS

REVISIONS		
No	DESCRIPTION	DATE

PROJECT INFORMATION

CONTRACT NO.:  
SC 08 19

VIWAPA PROJECT MANAGER:  
BRIAN LEONARD

VIWAPA PROJECT COORDINATOR:  
GHADIR AWAWADA


CONSTRUCTION START DATE:  
JUNE 9, 2019

CONSTRUCTION COMPLETION DATE:  
FEBRUARY 17, 2021

PRIME CONTRACTOR:  
LEUMAS ENGINEERING GROUP

PRIME CONTRACTOR CONTACT:  
STEPHEN SAMUEL  
shsamuel@gmail.com




QUEEN ST.  
PROFILE AND PLAN  
SECTION 3

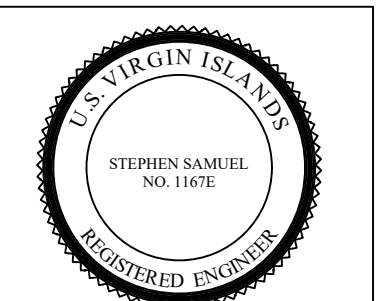


DATE	JULY 2021
DRAWN BY	SHS
SCALE	AS NOTED

C17





17 OF 27

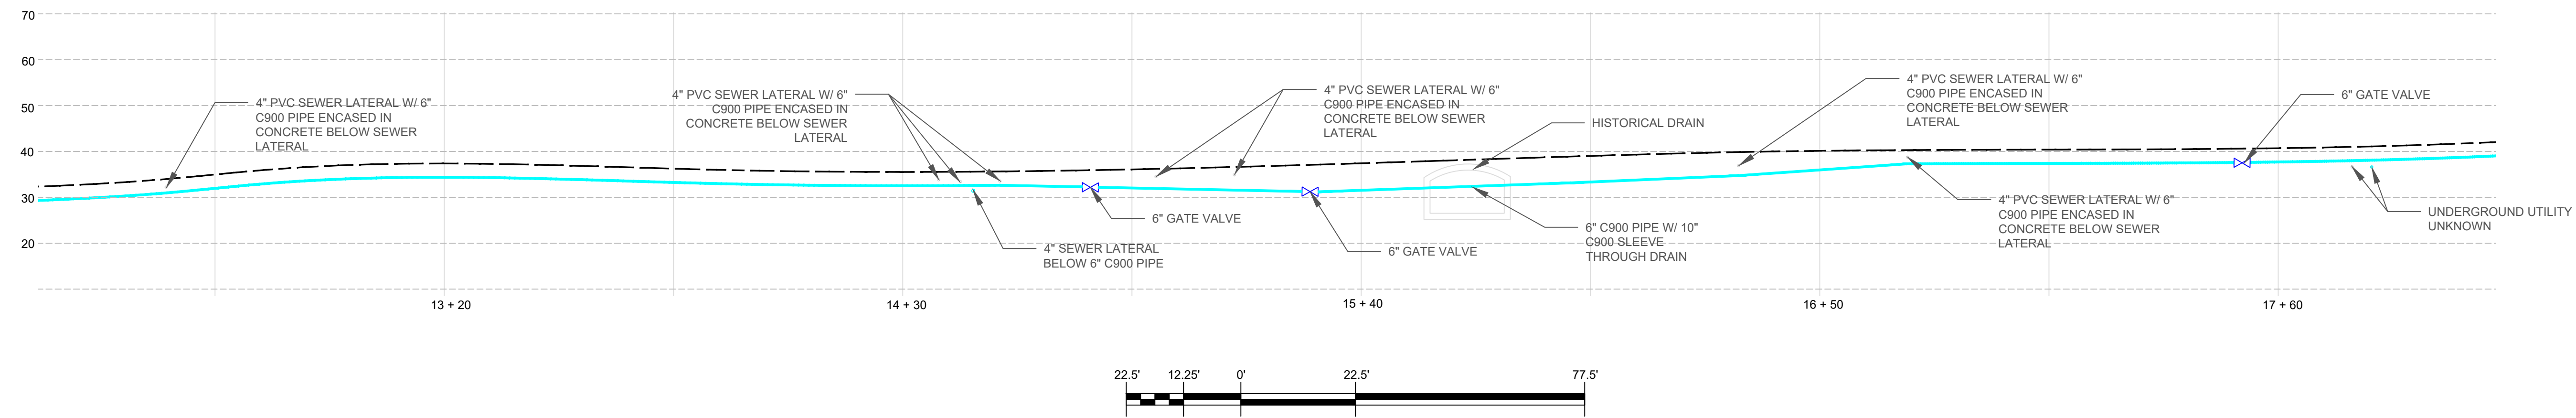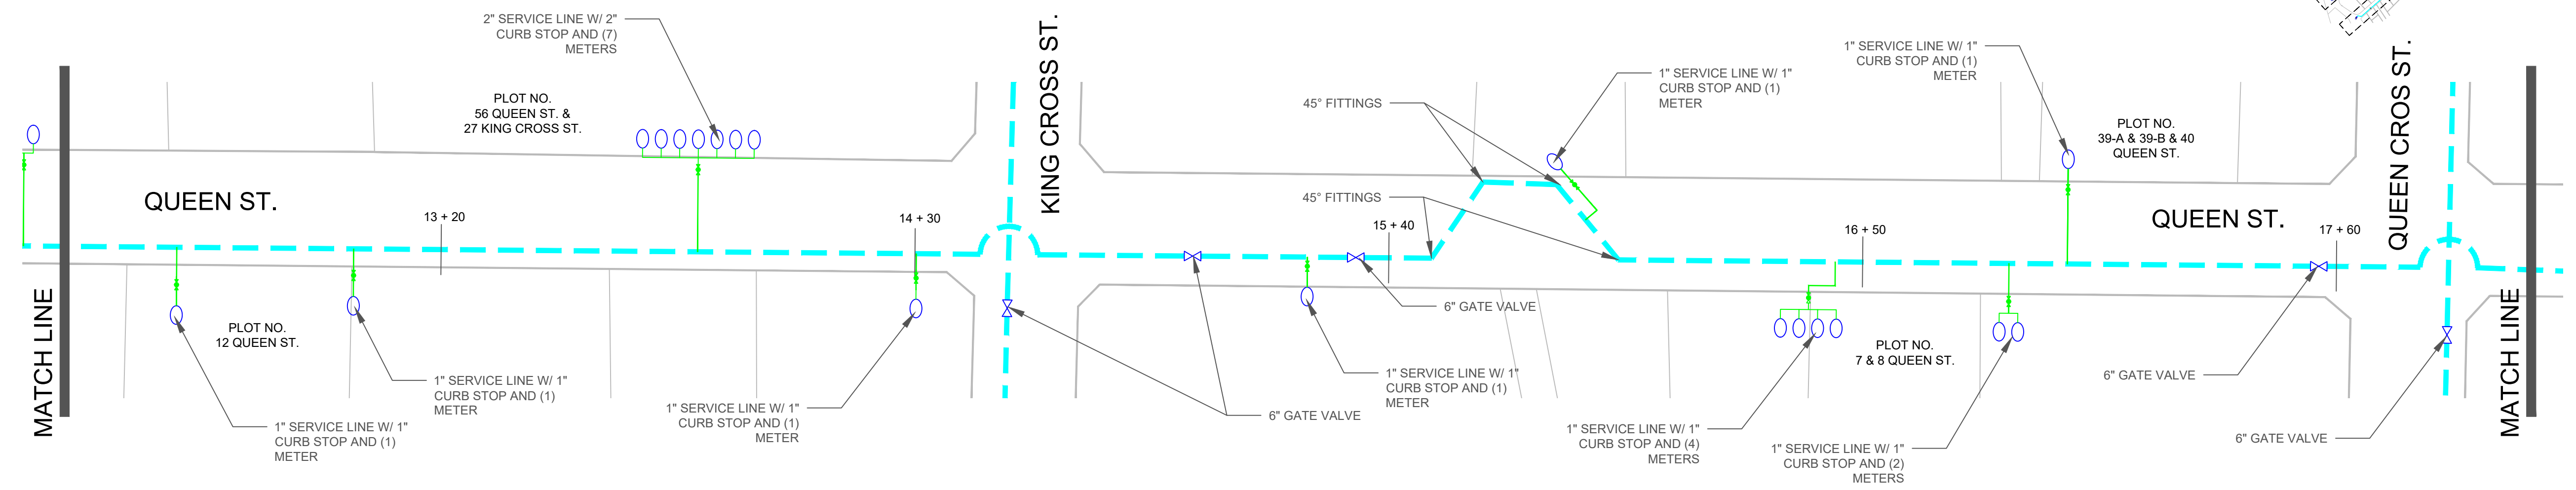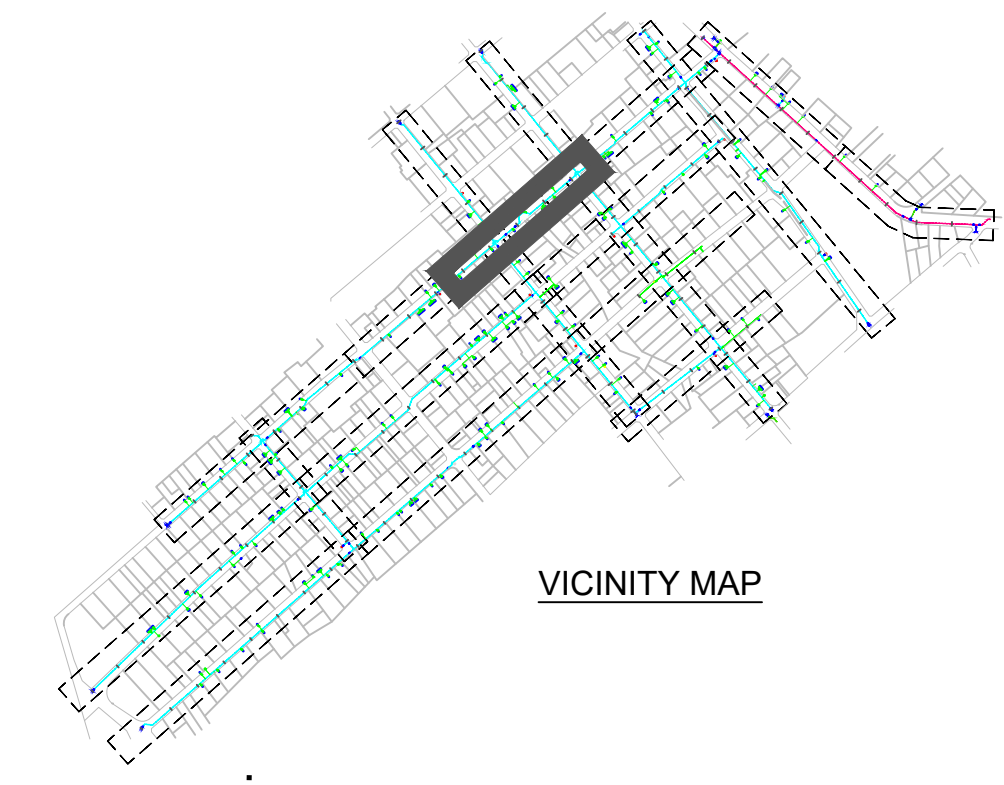




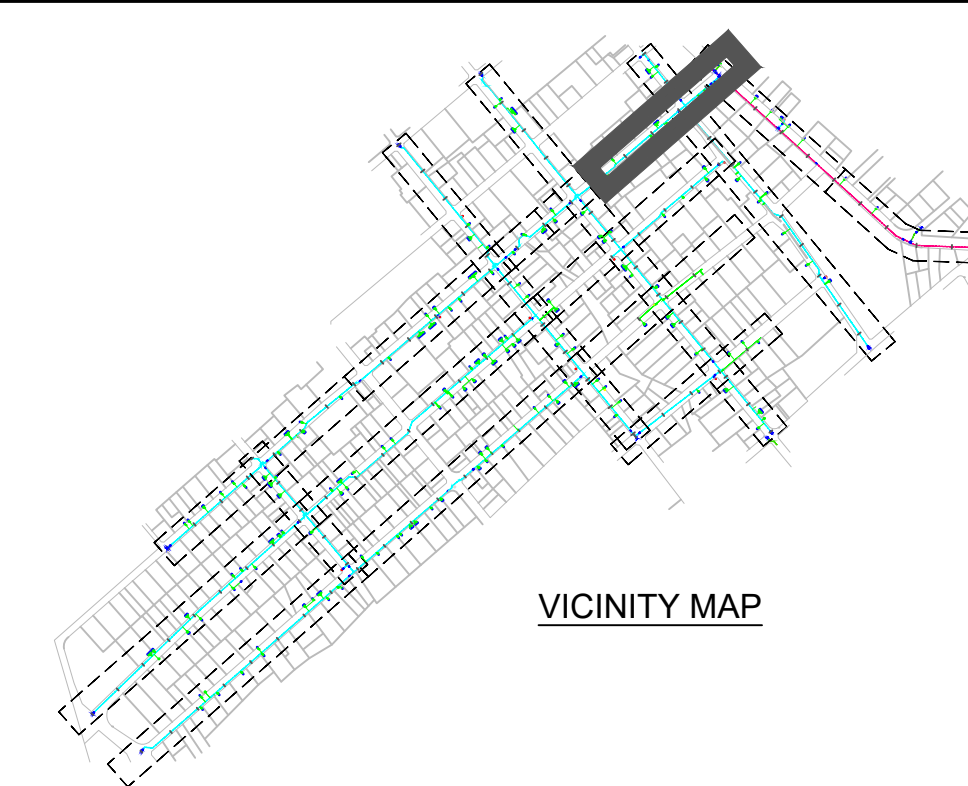

VICINITY MAP

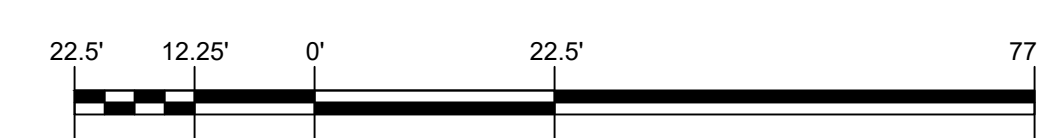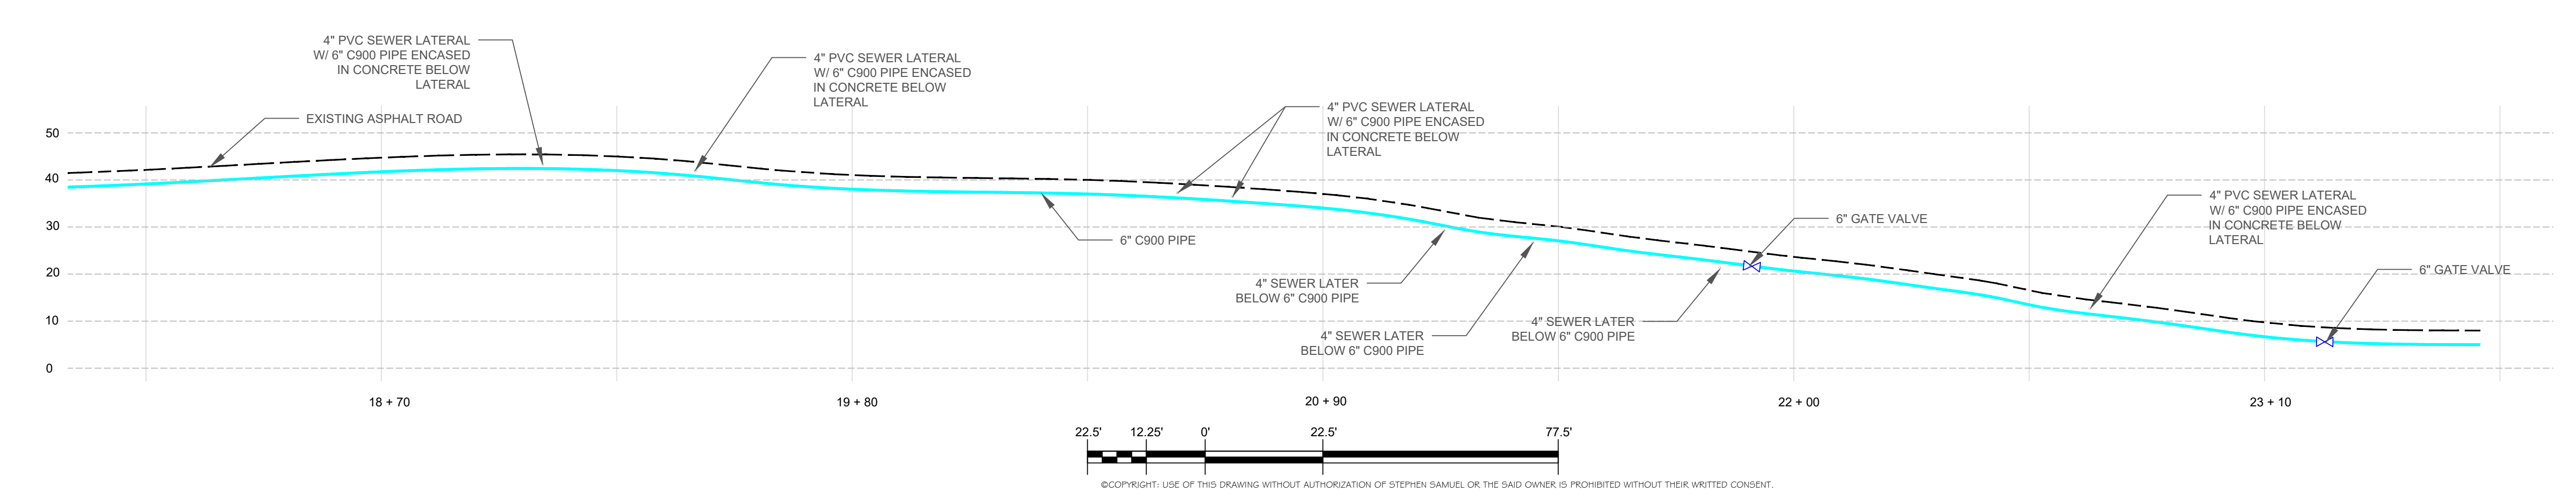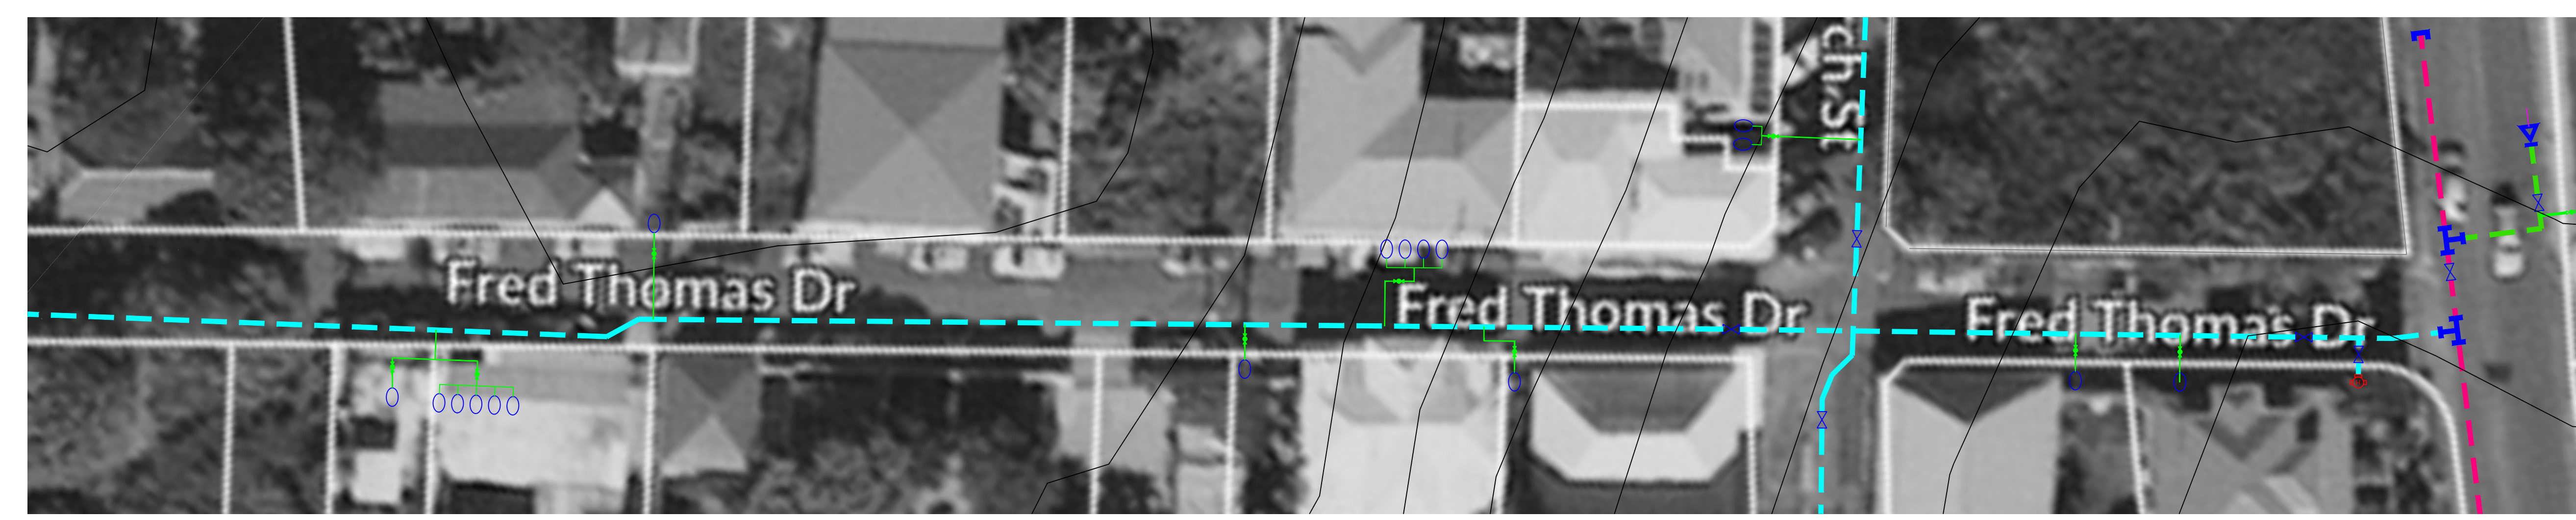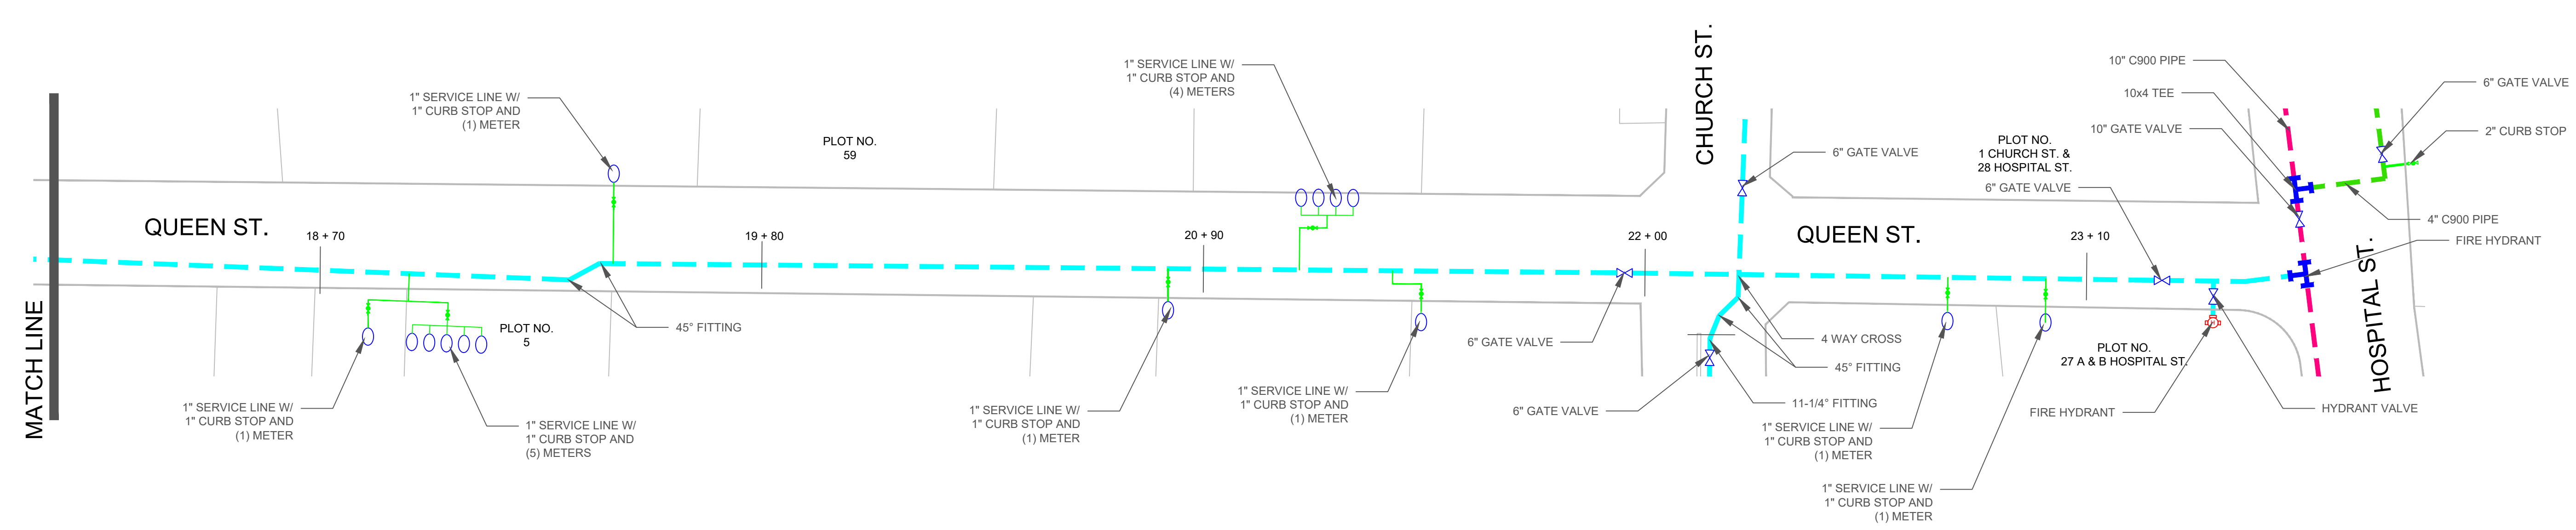

©COPYRIGHT: USE OF THIS DRAWING WITHOUT AUTHORIZATION OF STEPHEN SAMUEL OR THE SAID OWNER IS PROHIBITED WITHOUT THEIR WRITTEN CONSENT.

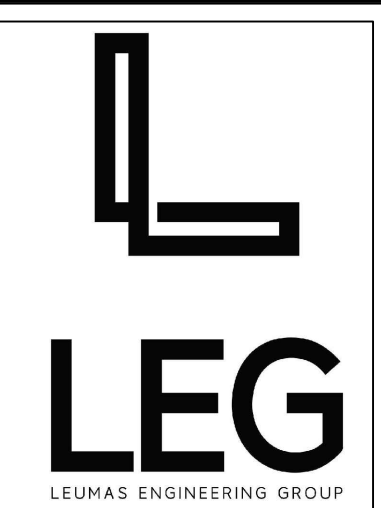

P.O. BOX 3520  
KINGSHILL, VI, 00851  
340.277.2788  
shsamuel@gmail.com

CHRISTIANSTOWN WATERLINE REHABILITATION AS-BUILT  
**VIRGIN ISLANDS WATER AND POWER AUTHORITY**  
P.O. BOX 1009 CHRISTIANSTED, ST. CROIX, U.S. VIRGIN ISLANDS

REVISIONS		
No	DESCRIPTION	DATE

PROJECT INFORMATION

CONTRACT NO.:  
SC 08 19

VIWAPA PROJECT MANAGER:  
BRIAN LEONARD

VIWAPA PROJECT COORDINATOR:  
GHADIR AWAWADA


CONSTRUCTION START DATE:  
JUNE 9, 2019

CONSTRUCTION COMPLETION DATE:  
FEBRUARY 17, 2021

PRIME CONTRACTOR:  
LEUMAS ENGINEERING GROUP

PRIME CONTRACTOR CONTACT:  
STEPHEN SAMUEL  
shsamuel@gmail.com

QUEEN ST.  
PROFILE AND PLAN  
SECTION 4

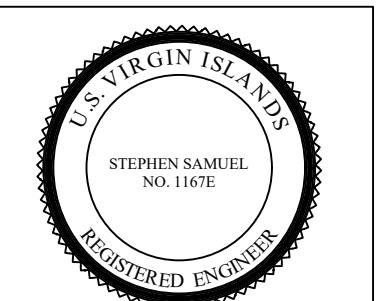

DATE JULY 2021	<b>C18</b>
DRAWN BY SHS	
SCALE AS NOTED	